

11-DEC-2012 14:37

Chad Havens


TIME\$\$\$ 006043ST26-1A
8825Full.pen

R:\07400004\006043\DGW\As Bullets\DGW\006043ST26-1A.dgn


STATE GA PROJECT NUMBER CSNHS-0006-00(043)

SHEET NO. 127 TOTAL SHEETS 668

AS-BUILT PLANS 12/12/12

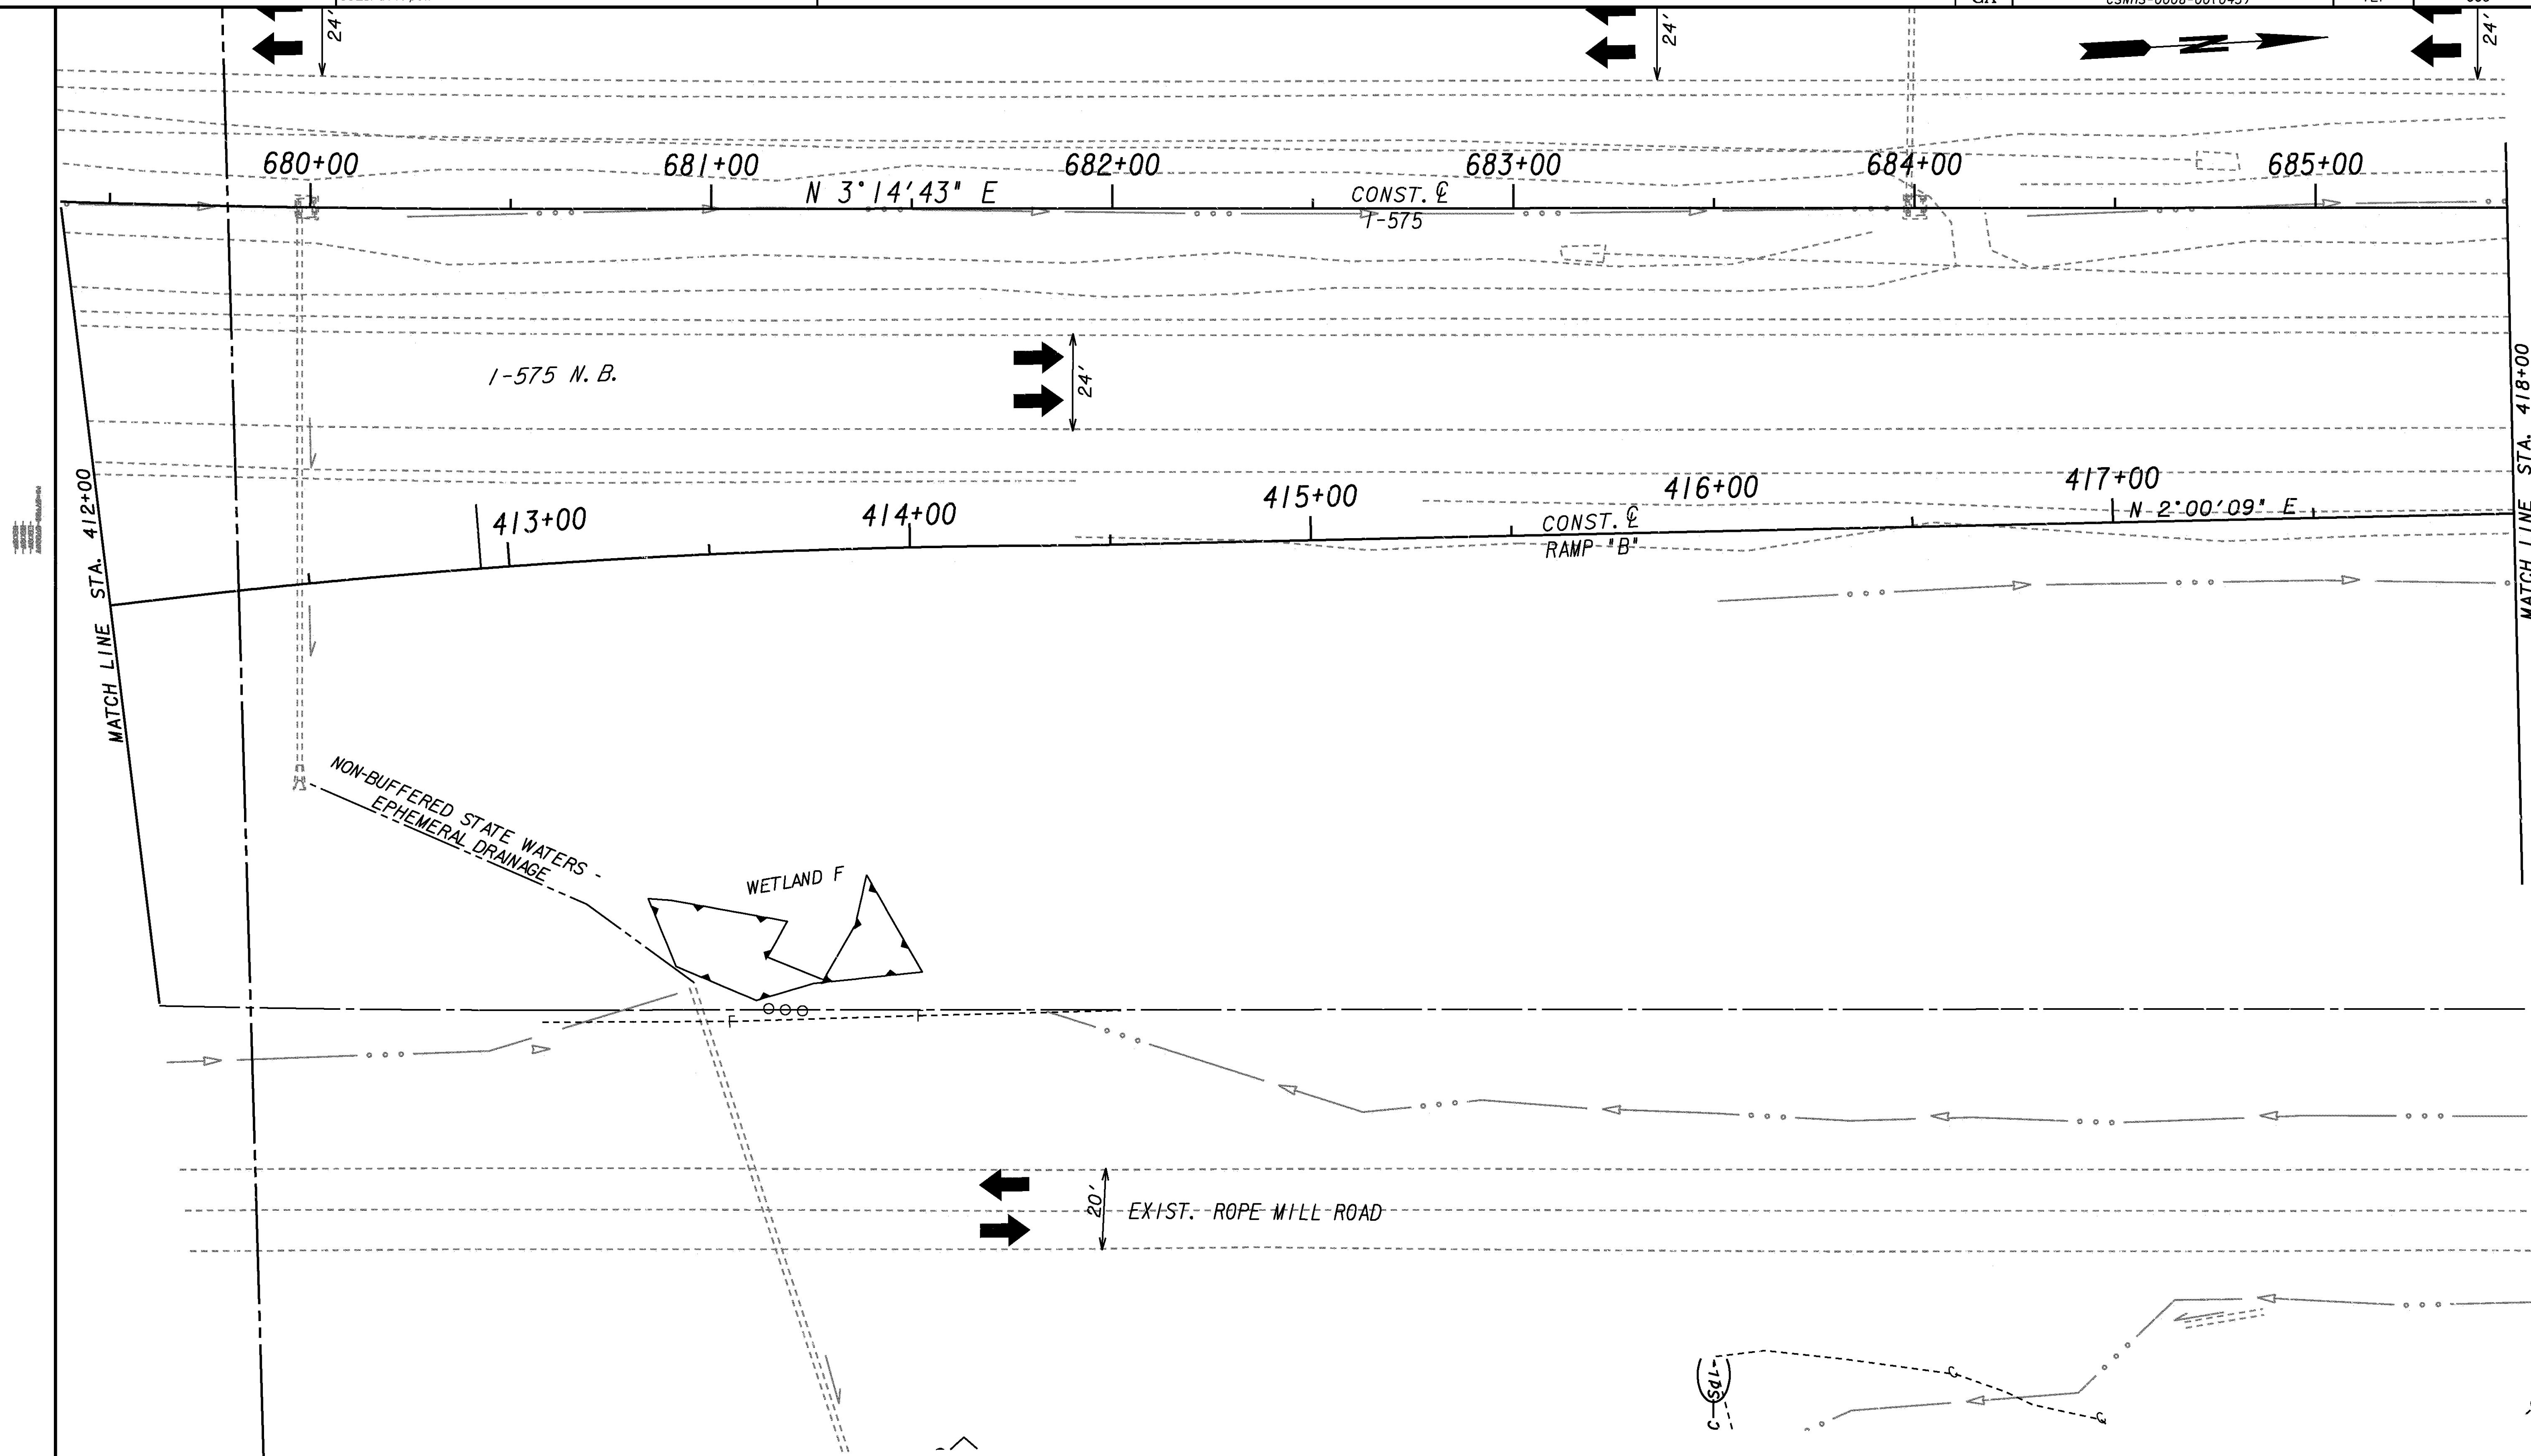

LEGEND

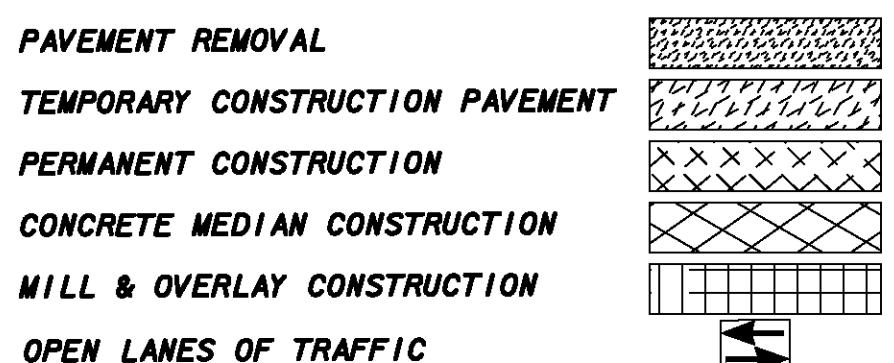

STAGE 1 PHASE 1

THE LPA GROUP **LPA**
TRANSPORTATION CONSULTANTS
3595 ENGINEERING DRIVE
NORCROSS, GEORGIA 30092
(770) 263-9118

SCALE IN FEET
0 20 40 60 80

REVISION DATES

STATE OF GEORGIA
DEPARTMENT OF TRANSPORTATION

OFFICE: INNOVATIVE PROGRAM DELIVERY

CONSTRUCTION STAGING
PLANI-575 NB ENTRANCE RAMP B
STA. 412+00 TO STA. 418+00DRAWING NO.
19-026